


Front (North East Facing) Elevation)1:100




Side Elevation

1:100

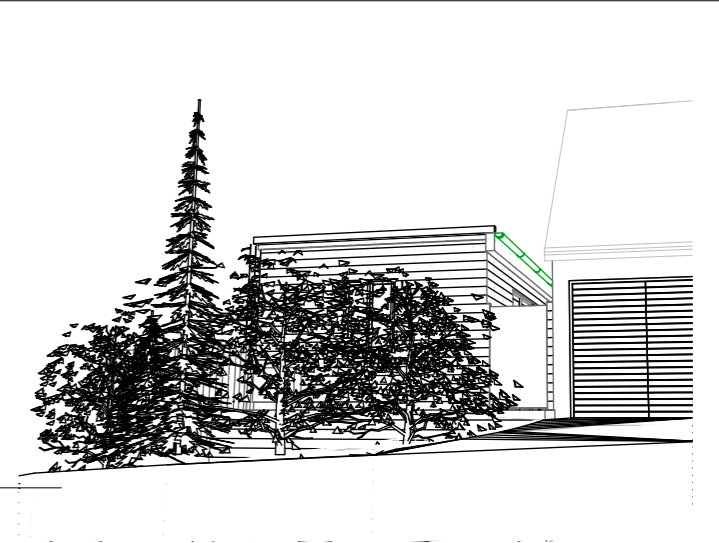


Existing View

1:100

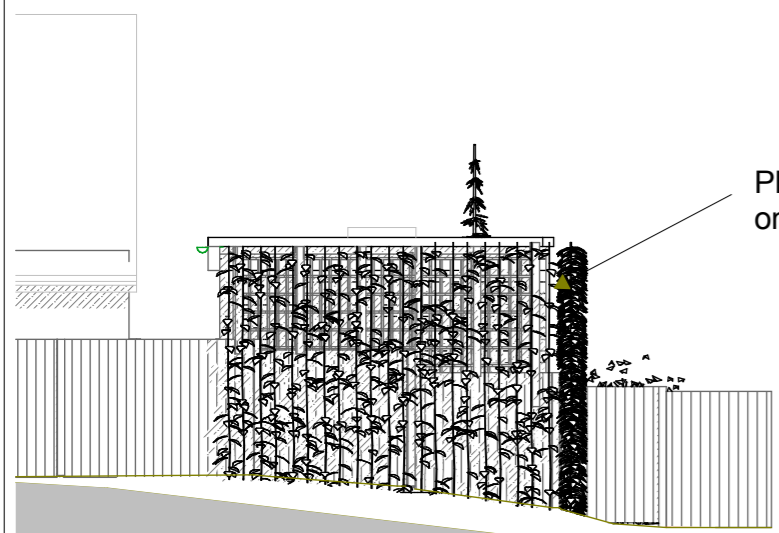


Rear Elevation

1:100

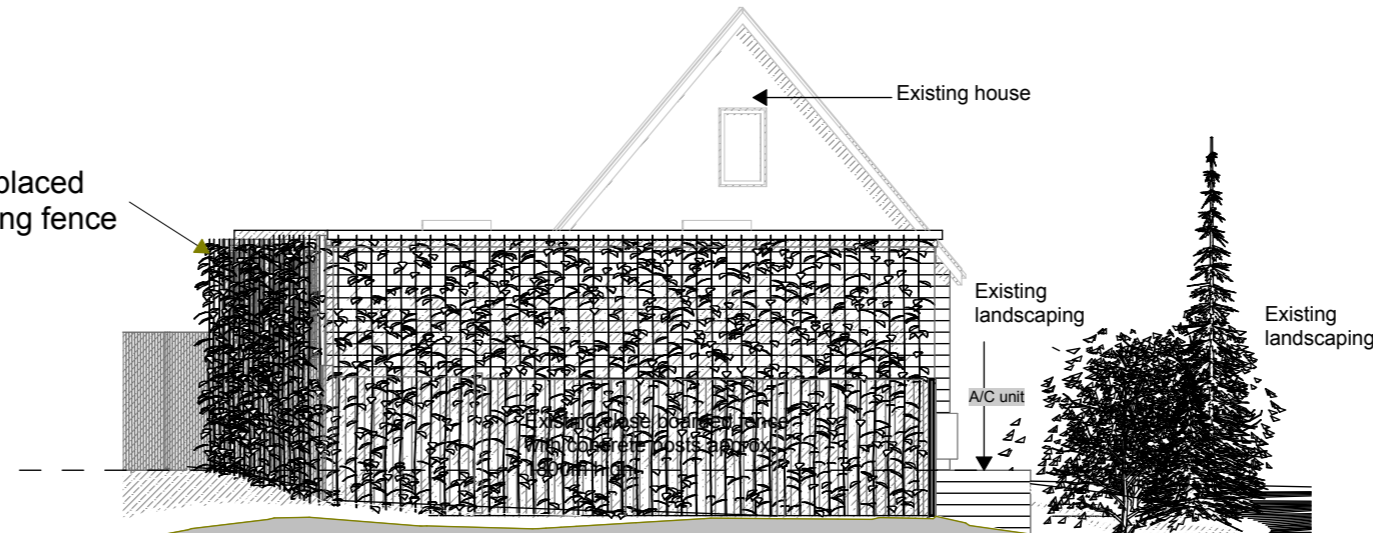


Side Elevation

1:100

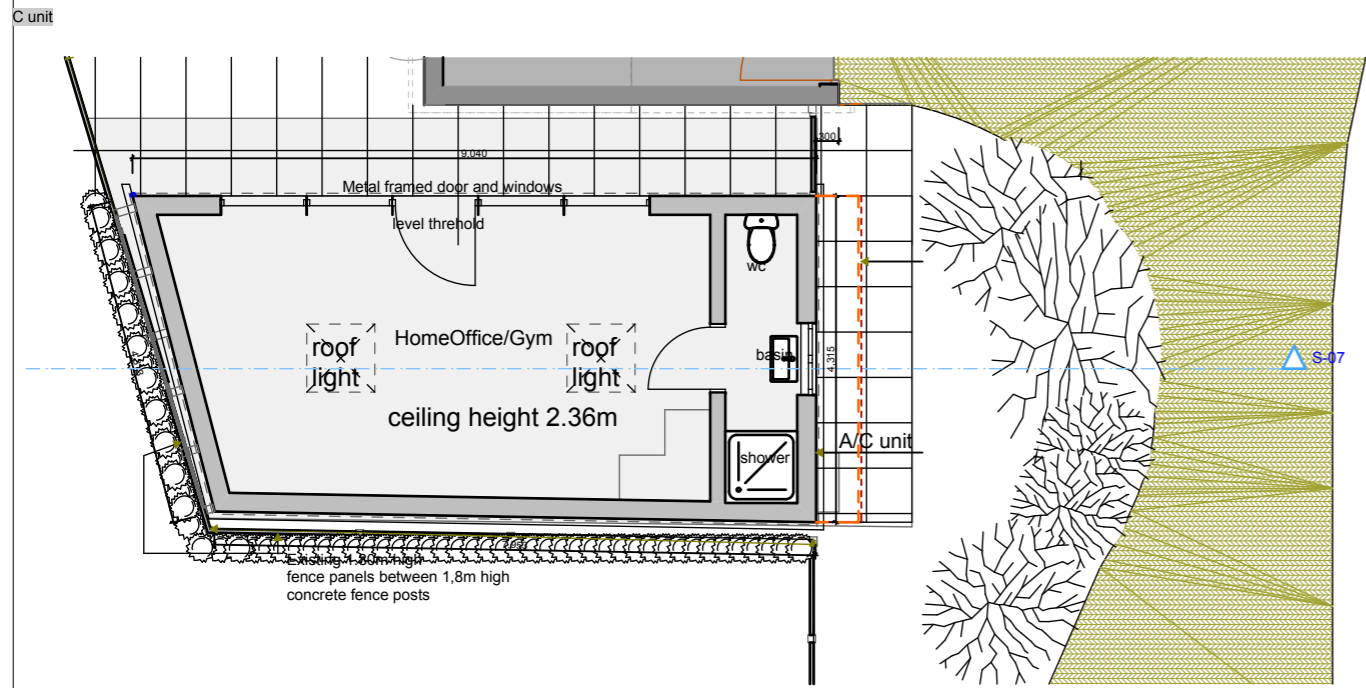

GF-Ground Floor (2)



1:100

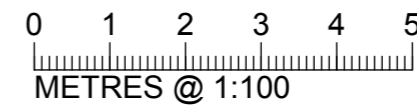



S-0

Rev D 09/12/21 Trellis and planting extended along side(South Eastern) boundary


Status Planning	Layout Title Plan and Elevations
Scales @ A3 1:100	Client Mr.B Shah 4 Waterfield, Heronsgate Herts
Project Retrospective Application Out-building - As Built	PFG DESIGN ARCHITECTS + DESIGNERS
Drawing Number 001D	Rev 07921886191 info@pfgdesign.co.uk www.pfgdesign.co.uk

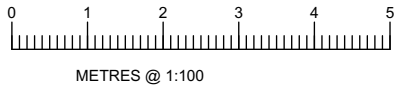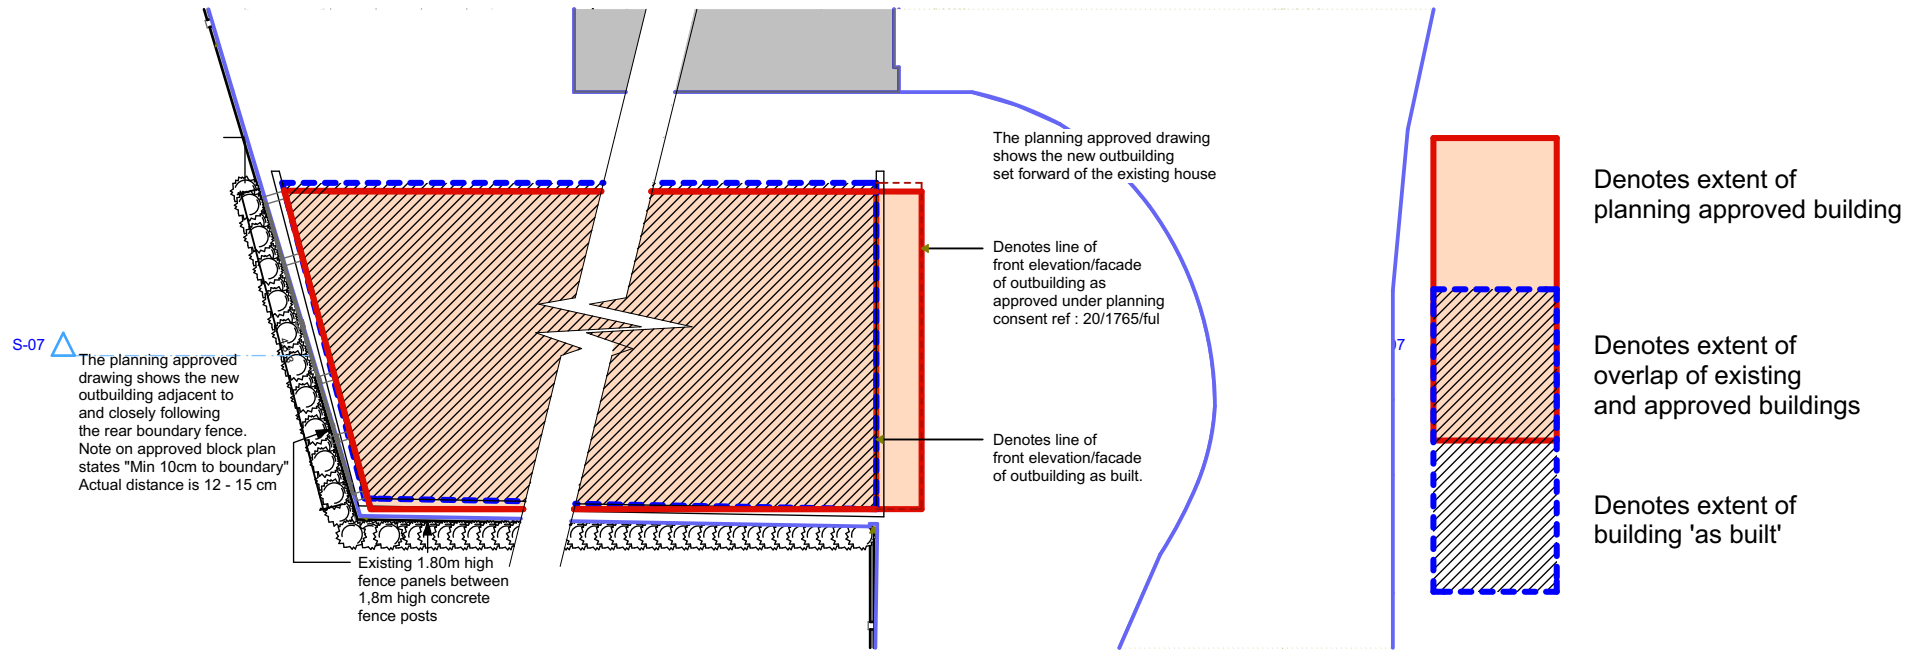



	Status	Layout Title	Approved outbuilding overlaid on actual site plan with outbuilding as erected.
	Scales @ A4	1:100	Client
Project		Retrospective Application Out-building - As Built	
Drawing Number		Rev	
9			

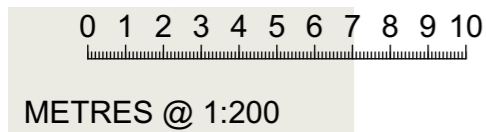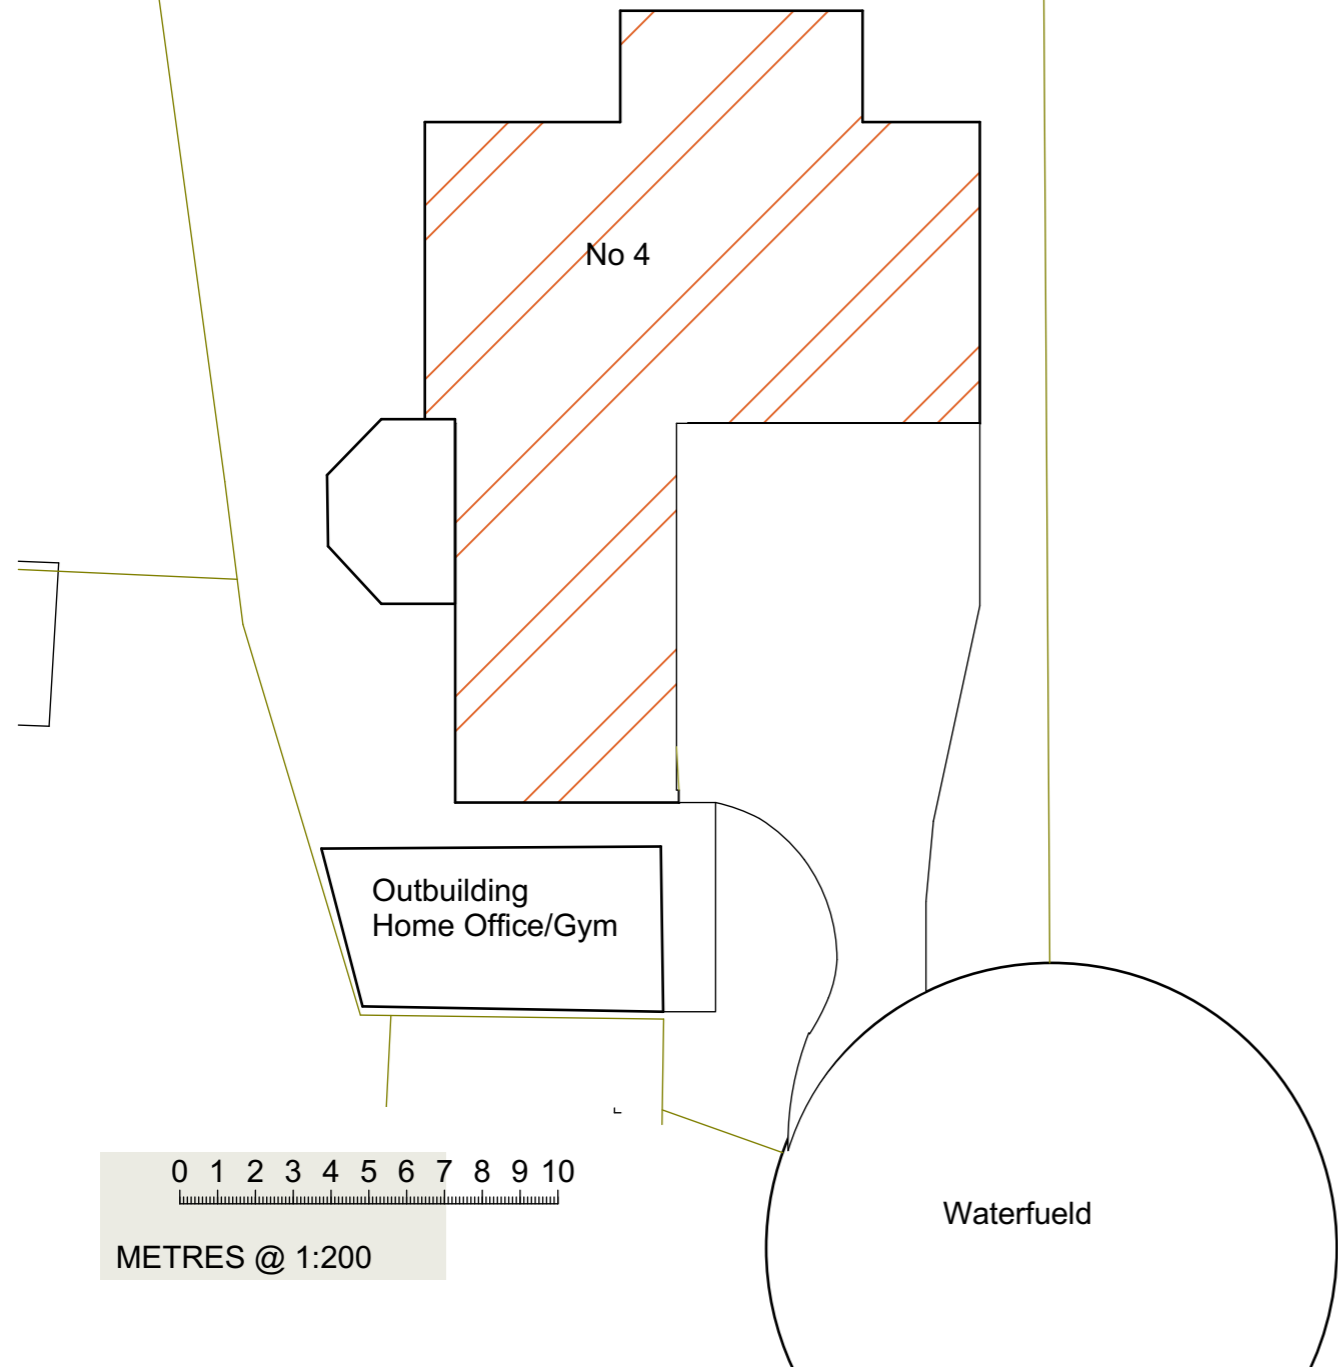

1 Block Plan 1:200

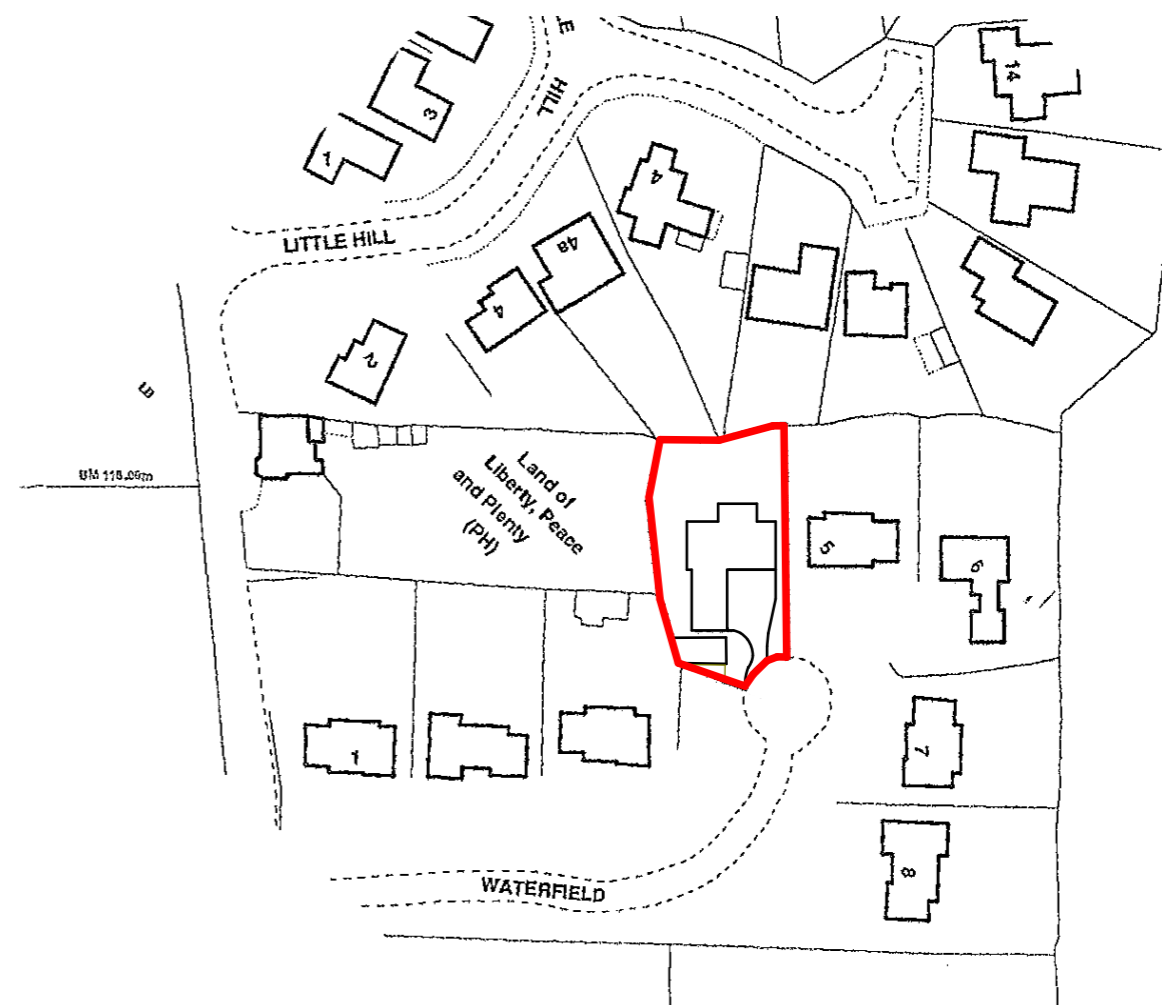

3 Location Plan 1:1250

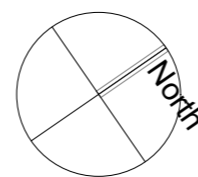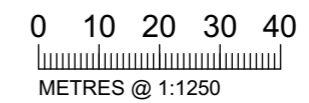

Status	Planning Application	Layout Title	Site Plan and Location Plan
	Scales @ A3		1:200, 1:1250
Client	Mr. B Shah 4 Waterfield, Heronsgate Herts		PFG DESIGN ARCHITECTS + DESIGNERS
	Project	Retrospective Application Out-building - As Built	
Drawing Number	002 B	Rev	07921886191 info@pfgdesign.co.uk www.pfgdesign.co.uk