




1 Block Plan 1:200

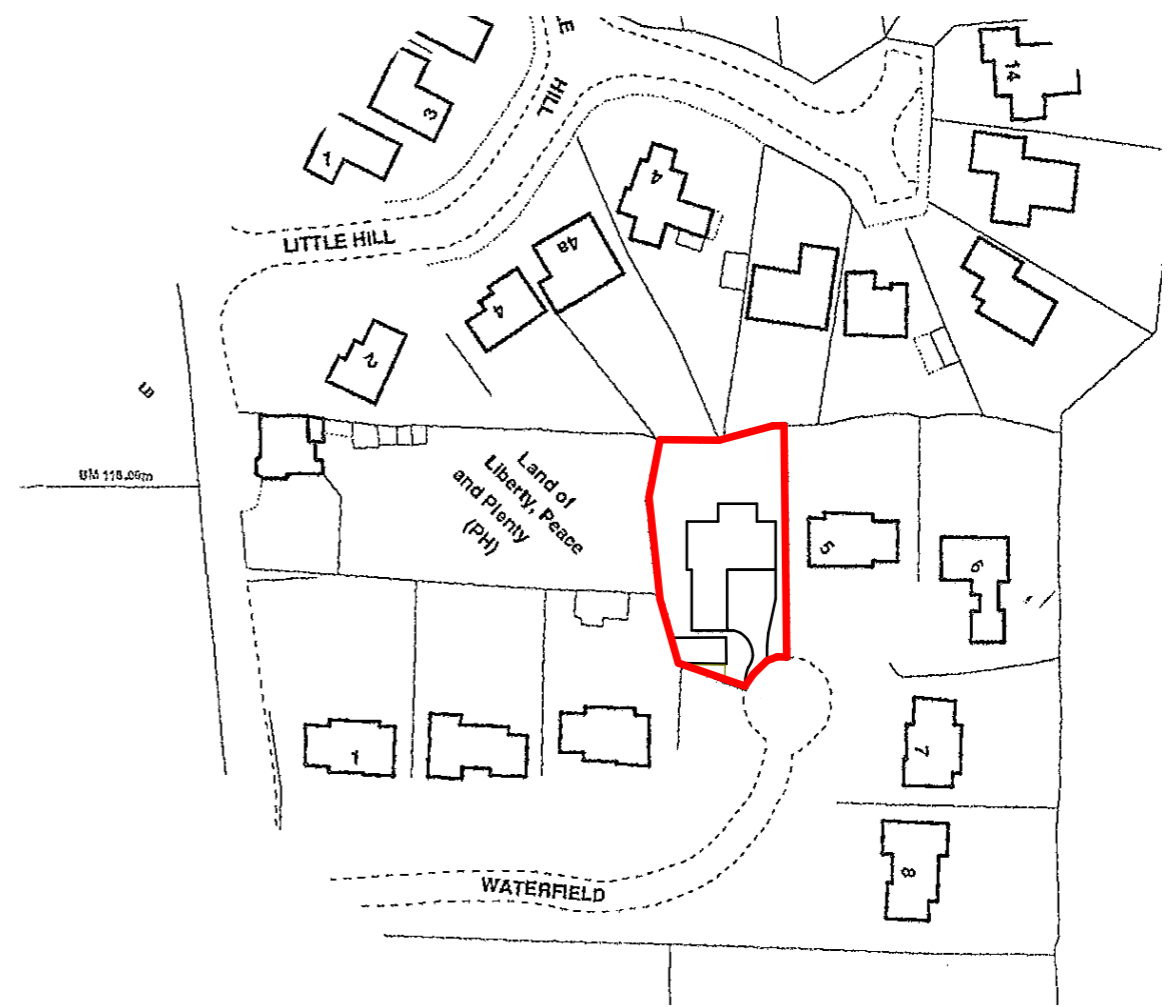

3 Location Plan 1:1250

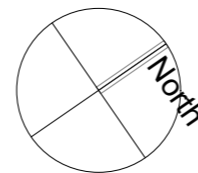


Status	Planning Application	Layout Title	Site Plan and Location Plan
Scales @ A3	1:200, 1:1250	Client	Mr.B Shah 4 Waterfield, Heronsgate Herts
Project	Retrospective Application Out-building - As Built	PFG DESIGN ARCHITECTS + DESIGNERS	
Drawing Number	002 B	Rev	07921886191 info@pfgdesign.co.uk www.pfgdesign.co.uk

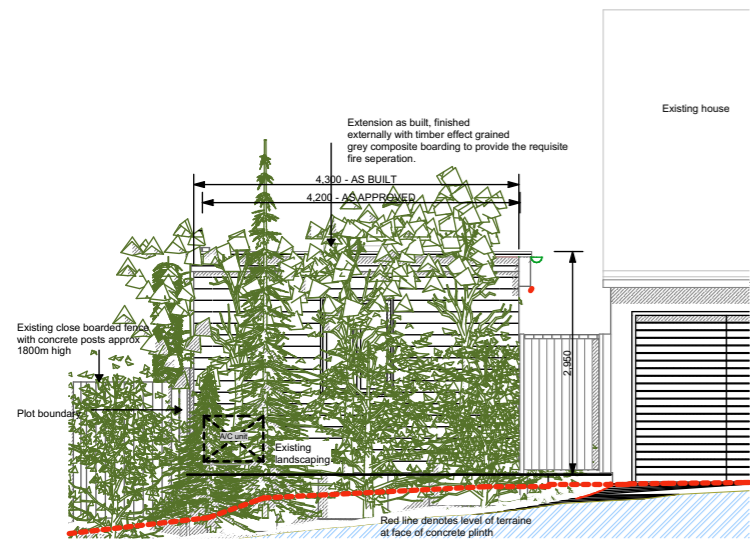

Front (North East Facing) Elevation) 1:100




Side Elevation 1:100

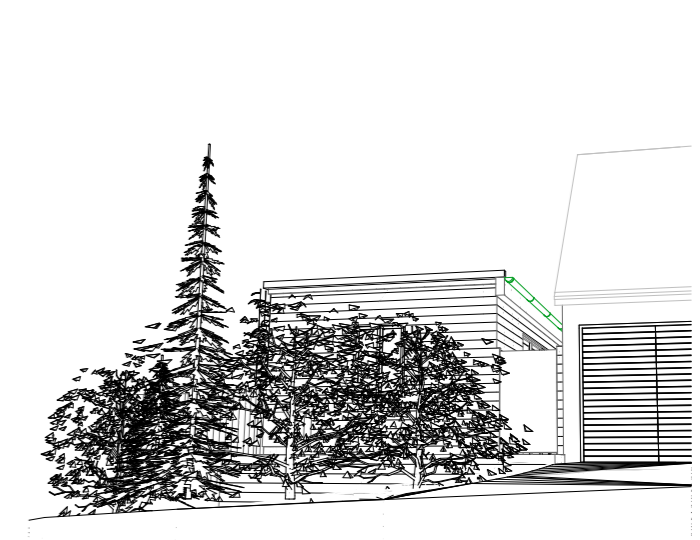


Existing View



Rear Elevation 1:100

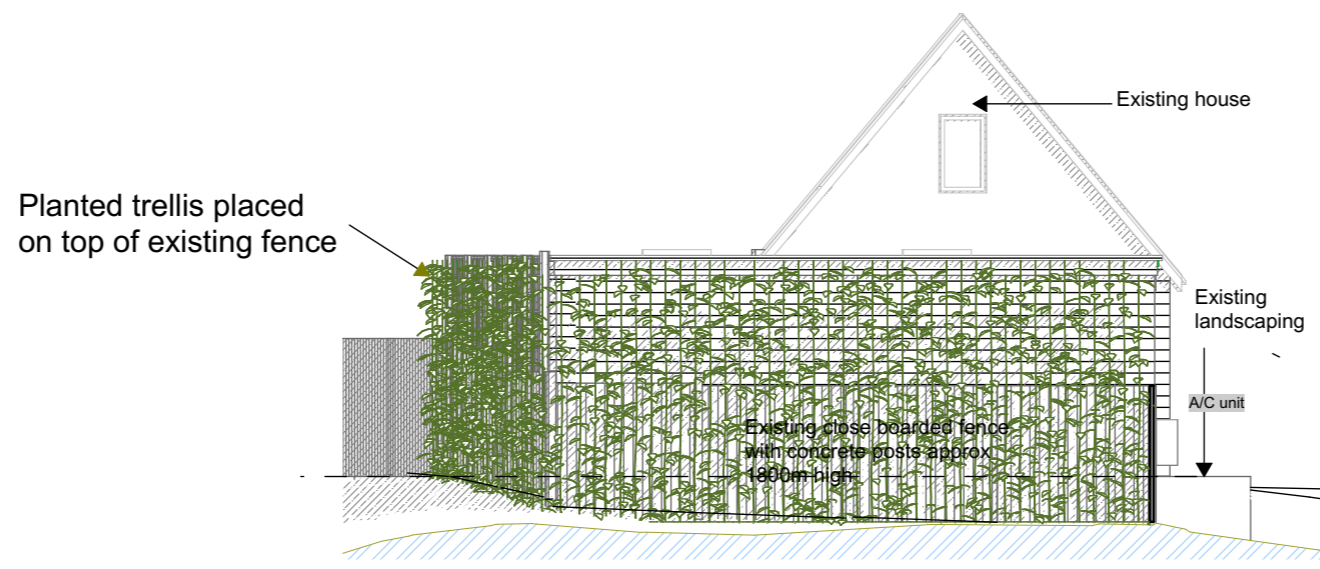

Side Elevation 1:100

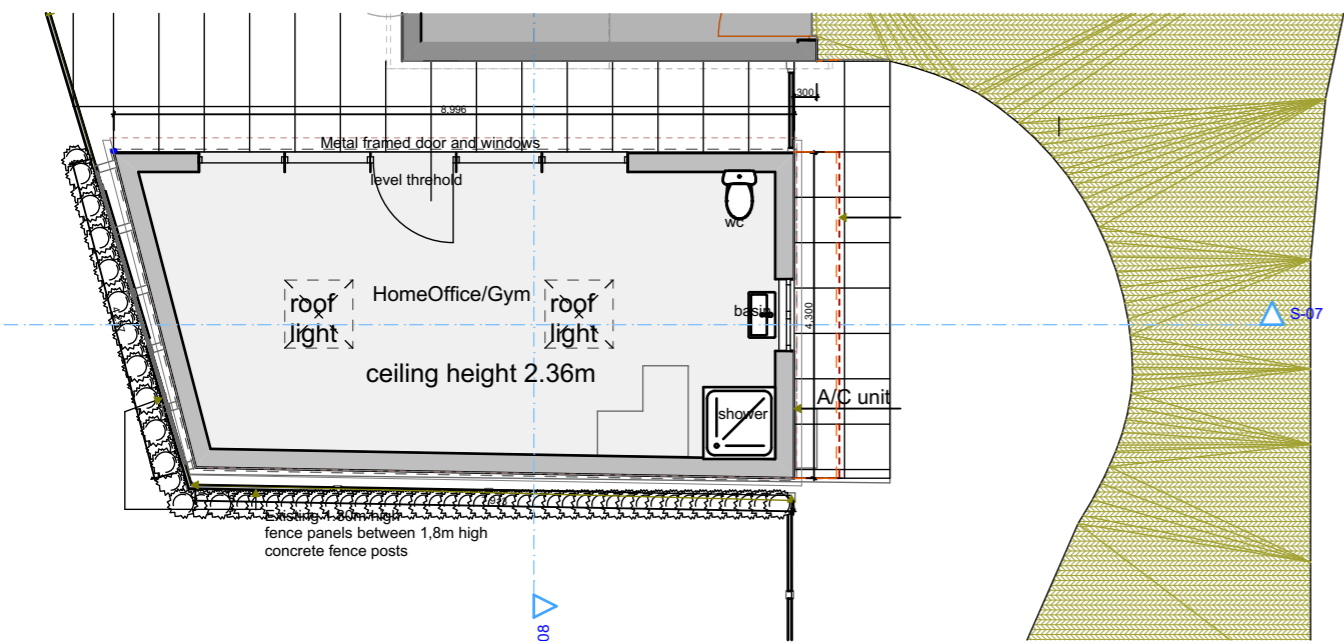

GF-Ground Floor (2) 1:100

Rev E 07/13/22 Building height clarified
Existing land profile shown on front elevation

Rev D 09/12/21 Trellis and planting extended along side(South Eastern) boundary

Status	Planning	Layout Title	Plan and Elevations
Scales @ A3	1:100, 1:2	Client	Mr.B Shah 4 Waterfield, Heronsgate Herts
Project	Retrospective Application Out-building - As Built		PFG DESIGN ARCHITECTS + DESIGNERS
Drawing Number	001E	Rev	07921886191 info@pfgdesign.co.uk www.pfgdesign.co.uk



UltraShield® Naturale™

UltraShield™'s unique design and colour choices will bring your decking project to life.

UltraShield® latest Naturale™ product range features a unique treatment on the Shield. It's the most natural feeling capped composite available. Walk barefoot or lie down in comfort. With no splinters you can be sure that kids and family pets can safely enjoy the decking.

And with UltraShield™'s built in protection against UV rays. Don't worry about colour fading. Your decking will remain beautiful for years to come.

Colour Collection

Oak, Teak, Antique, Silver Grey, Light Grey, Charcoal & Ebony

Pattern Selection

H1, H6